

FIRE SYSTEM, WIRING DIAGRAM

Project Title
VGL Plaquemines I - 100MW Temporary Power Island (TPI) 4x LM2500-XPRESS Turbine Generator Package
Owner
Venture Global Plaquemines LNG, LLC
Customer/EPC
Baker-Hughes

Cross checked			
Department	Name	Date	Signature

Revision History					
Rev.	Revision date	Created By	Checked by	Approved by	Brief Description
B	10/26/2023				Initial issue
Description of current revision					

Replaces		Customer Code EX00U78		Project Document Code					
Responsible Dept. PE - PEM		Created by		Checked by		Approved by		Format ANSI B	
 GE VERNOVA		Document Type Supplier Drawing			Document Status Released		Issued As IFI		
		Document Title FIRE SYSTEM, WIRING DIAGRAM			Identification Number SW-MC_rB				
GAS POWER					Rev. B	Date 2023-10-26	Lang. en	Sheet Cover	
GBM Gas Master Doc Temp (ZZZ)									


© 2023 GE Vernova and/or its affiliates. All rights reserved.

All rights reserved. The information herein is Proprietary and Technically Exclusive content that is solely owned by General Electric Company and/or its affiliates. Thus, it is being provided with the explicit expectation of restricted and privileged use. All recipients of this information shall be deemed to have agreed not to make duplications, reproductions of any nature by any means, modifications, disclosures, or use any portion of this material; except as is expressly authorized in writing by the General Electric Company, and/or its legitimate affiliates.

LEGEND:
SEE 000005 ELECTRICAL SYMBOLS, ABBREVIATIONS AND REFERENCE DATA

- NOTE:
1. APPLICABLE STANDARD/SPECIFICATION:
IEEE 315–1975 GRAPHIC SYMBOLS FOR ELECTRICAL AND ELECTRONIC DIAGRAMMS.
 2. CUSTOMER DRAWING NUMBERS CONSIST OF: (ORDER NUMBER)– (STANDARD DRAWING NUMBER), AND ARE REFERENCED AS X–(STANDARD DRAWING NUMBER), WHERE X= ORDER NUMBER.

3. THE REPRESENTATION BELOW IS FOR THE RSTI–EP DISTRIBUTION I/O MODULES:

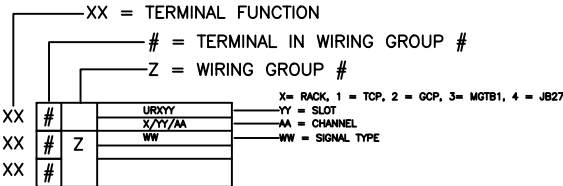

4. ALL DEVICES SHOWN DE–ENERGIZED (SHELF STATE).
5. FOR CORRECT INSTALLATION OF IR GAS SENSORS, ENSURE SAMPLING HOLES ON INLET TUBE ARE ROTATED WITH HOLES OPPOSING EXHAUST AIRFLOW AND ENSURE THAT CAP IS PRESENT ON INLET TUBE. ENSURE OUTLET TUBE CUT TIP IS ROTATED WITH ANGLE POINTED UPWARD (CONSISTENT WITH AIRFLOW) AND IS 3 INCHES SHORTER THAN THE INLET TUBE.


REFERENCE DRAWINGS:
000005 ELECTRICAL SYMBOLS, ABBREVIATIONS AND REFERENCE DATA
X–951767 SCHEMATIC DIAGRAM, DC POWER DISTRIBUTION
X–951768 SCHEMATIC DIAGRAM, CRITICAL SHUTDOWN PATH
X–951934 SYSTEM SCHEMATIC, COMMUNICATION

REVISIONS			
REV	DESCRIPTION	DATE	BY
A	ISSUED FOR APPROVAL	07/13/20	MP
B	REVISED PER CUSTOMER COMMENTS	09/10/20	MP

THIS DRAWING, DESIGN AND THE DATA CONTAINED THEREIN IS THE PROPERTY OF WILSON FIRE EQUIPMENT AND IS NOT TO BE DISTRIBUTED TO OR USED BY OTHERS WITHOUT THE EXPRESSED WRITTEN CONSENT OF WILSON FIRE EQUIPMENT.


SCALE:	AS SHOWN	DATE
DRAWN:	MP	07/13/20
CHECKED:	JV	09/10/20
APPROVED:	JV	09/10/20

WILSON FIRE EQUIPMENT & SERVICE CO. 7303 EMPIRE CENTRAL DRIVE HOUSTON, TEXAS 77040 (713) 896–4747		
CUSTOMER INFORMATION		
G.E. PACKAGED POWER L.P.		
TM2500 GEN 9 / LM2500 XPRESS		
SYSTEM WIRING LEGEND FIRE & GAS DETECTION/ AEROSOL SUPPRESSION SYSTEM WFE PROJECT # GE–MC		

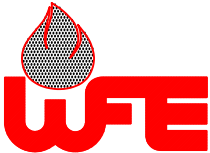		
SIZE	DRAWING NO.	REV
B	SW–MC–01 SHEET 1 OF 9	B

AUXILIARY SKID
BATTERY CHARGER CABINET

CONTROL HOUSE
TURBINE CONTROL PANEL

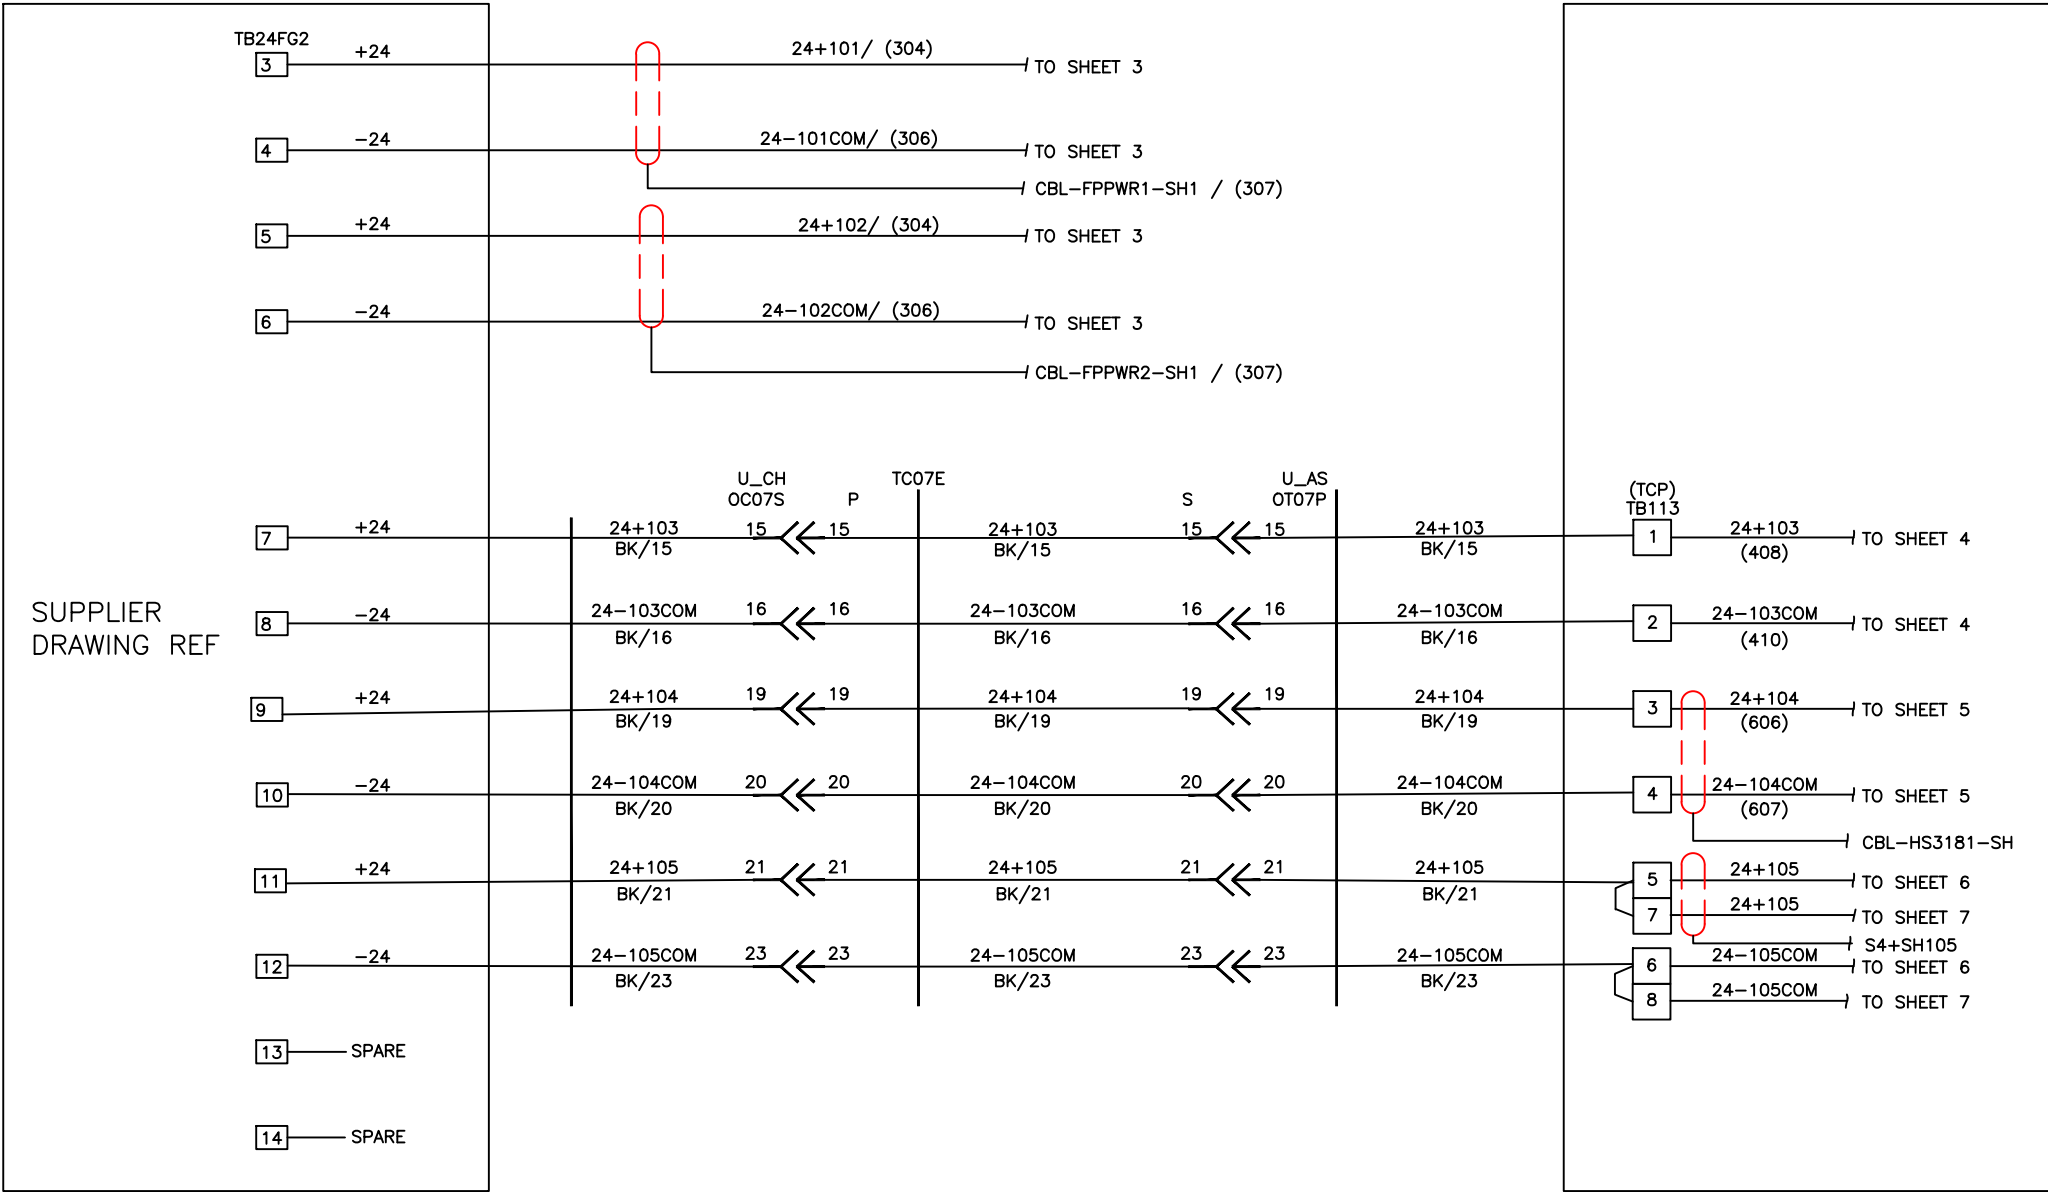

LIST OF 24 VDC POWER FEED

	FUNCTION	FUSE/CB DES	FUSE/CB RATING	FEEDER
1	FIRE & GAS PROTECTION PANEL	CB24FG3	10 AMP	24+101 24-101COM
2	FIRE & GAS PROTECTION PANEL	CB24FG4	10 AMP	24+102 24-102COM
3	TCP EDIO-1 MODULE	CB24FG5	10 AMP	24+103 24-103COM
4	TCP EDIO-2 MODULE	CB24FG6	10 AMP	24+104 24-104COM
5	GAS DETECTORS	CB24FG7	10 AMP	24+105 24-105COM
6	SPARE	CB24FG8	10 AMP	24+106 24-106COM

[illegible]

THIS DRAWING, DESIGN AND THE DATA CONTAINED THEREIN IS THE PROPERTY OF WILSON FIRE EQUIPMENT AND IS NOT TO BE DISTRIBUTED TO OR USED BY OTHERS WITHOUT THE EXPRESSED WRITTEN CONSENT OF WILSON FIRE EQUIPMENT.

SCALE:	AS SHOWN	DATE
DRAWN:	MP	07/13/20
CHECKED:	JV	09/10/20
APPROVED:	JV	09/10/20

WILSON FIRE EQUIPMENT & SERVICE CO.
7303 EMPIRE CENTRAL DRIVE HOUSTON, TEXAS 77040 (713) 896-4747

CUSTOMER INFORMATION

G.E. PACKAGED POWER L.P.


TM2500 GEN 9 / LM2500 XPRESS

POWER DISTRIBUTION WIRING
FIRE & GAS DETECTION/
AEROSOL SUPPRESSION SYSTEM
WFE PROJECT # GE-MC



SIZE	DRAWING NO.	REV
B	SW-MC-02 SHEET 2 OF 9	B

CONTROL HOUSE GENERATOR CONTROL PANEL (GCP)

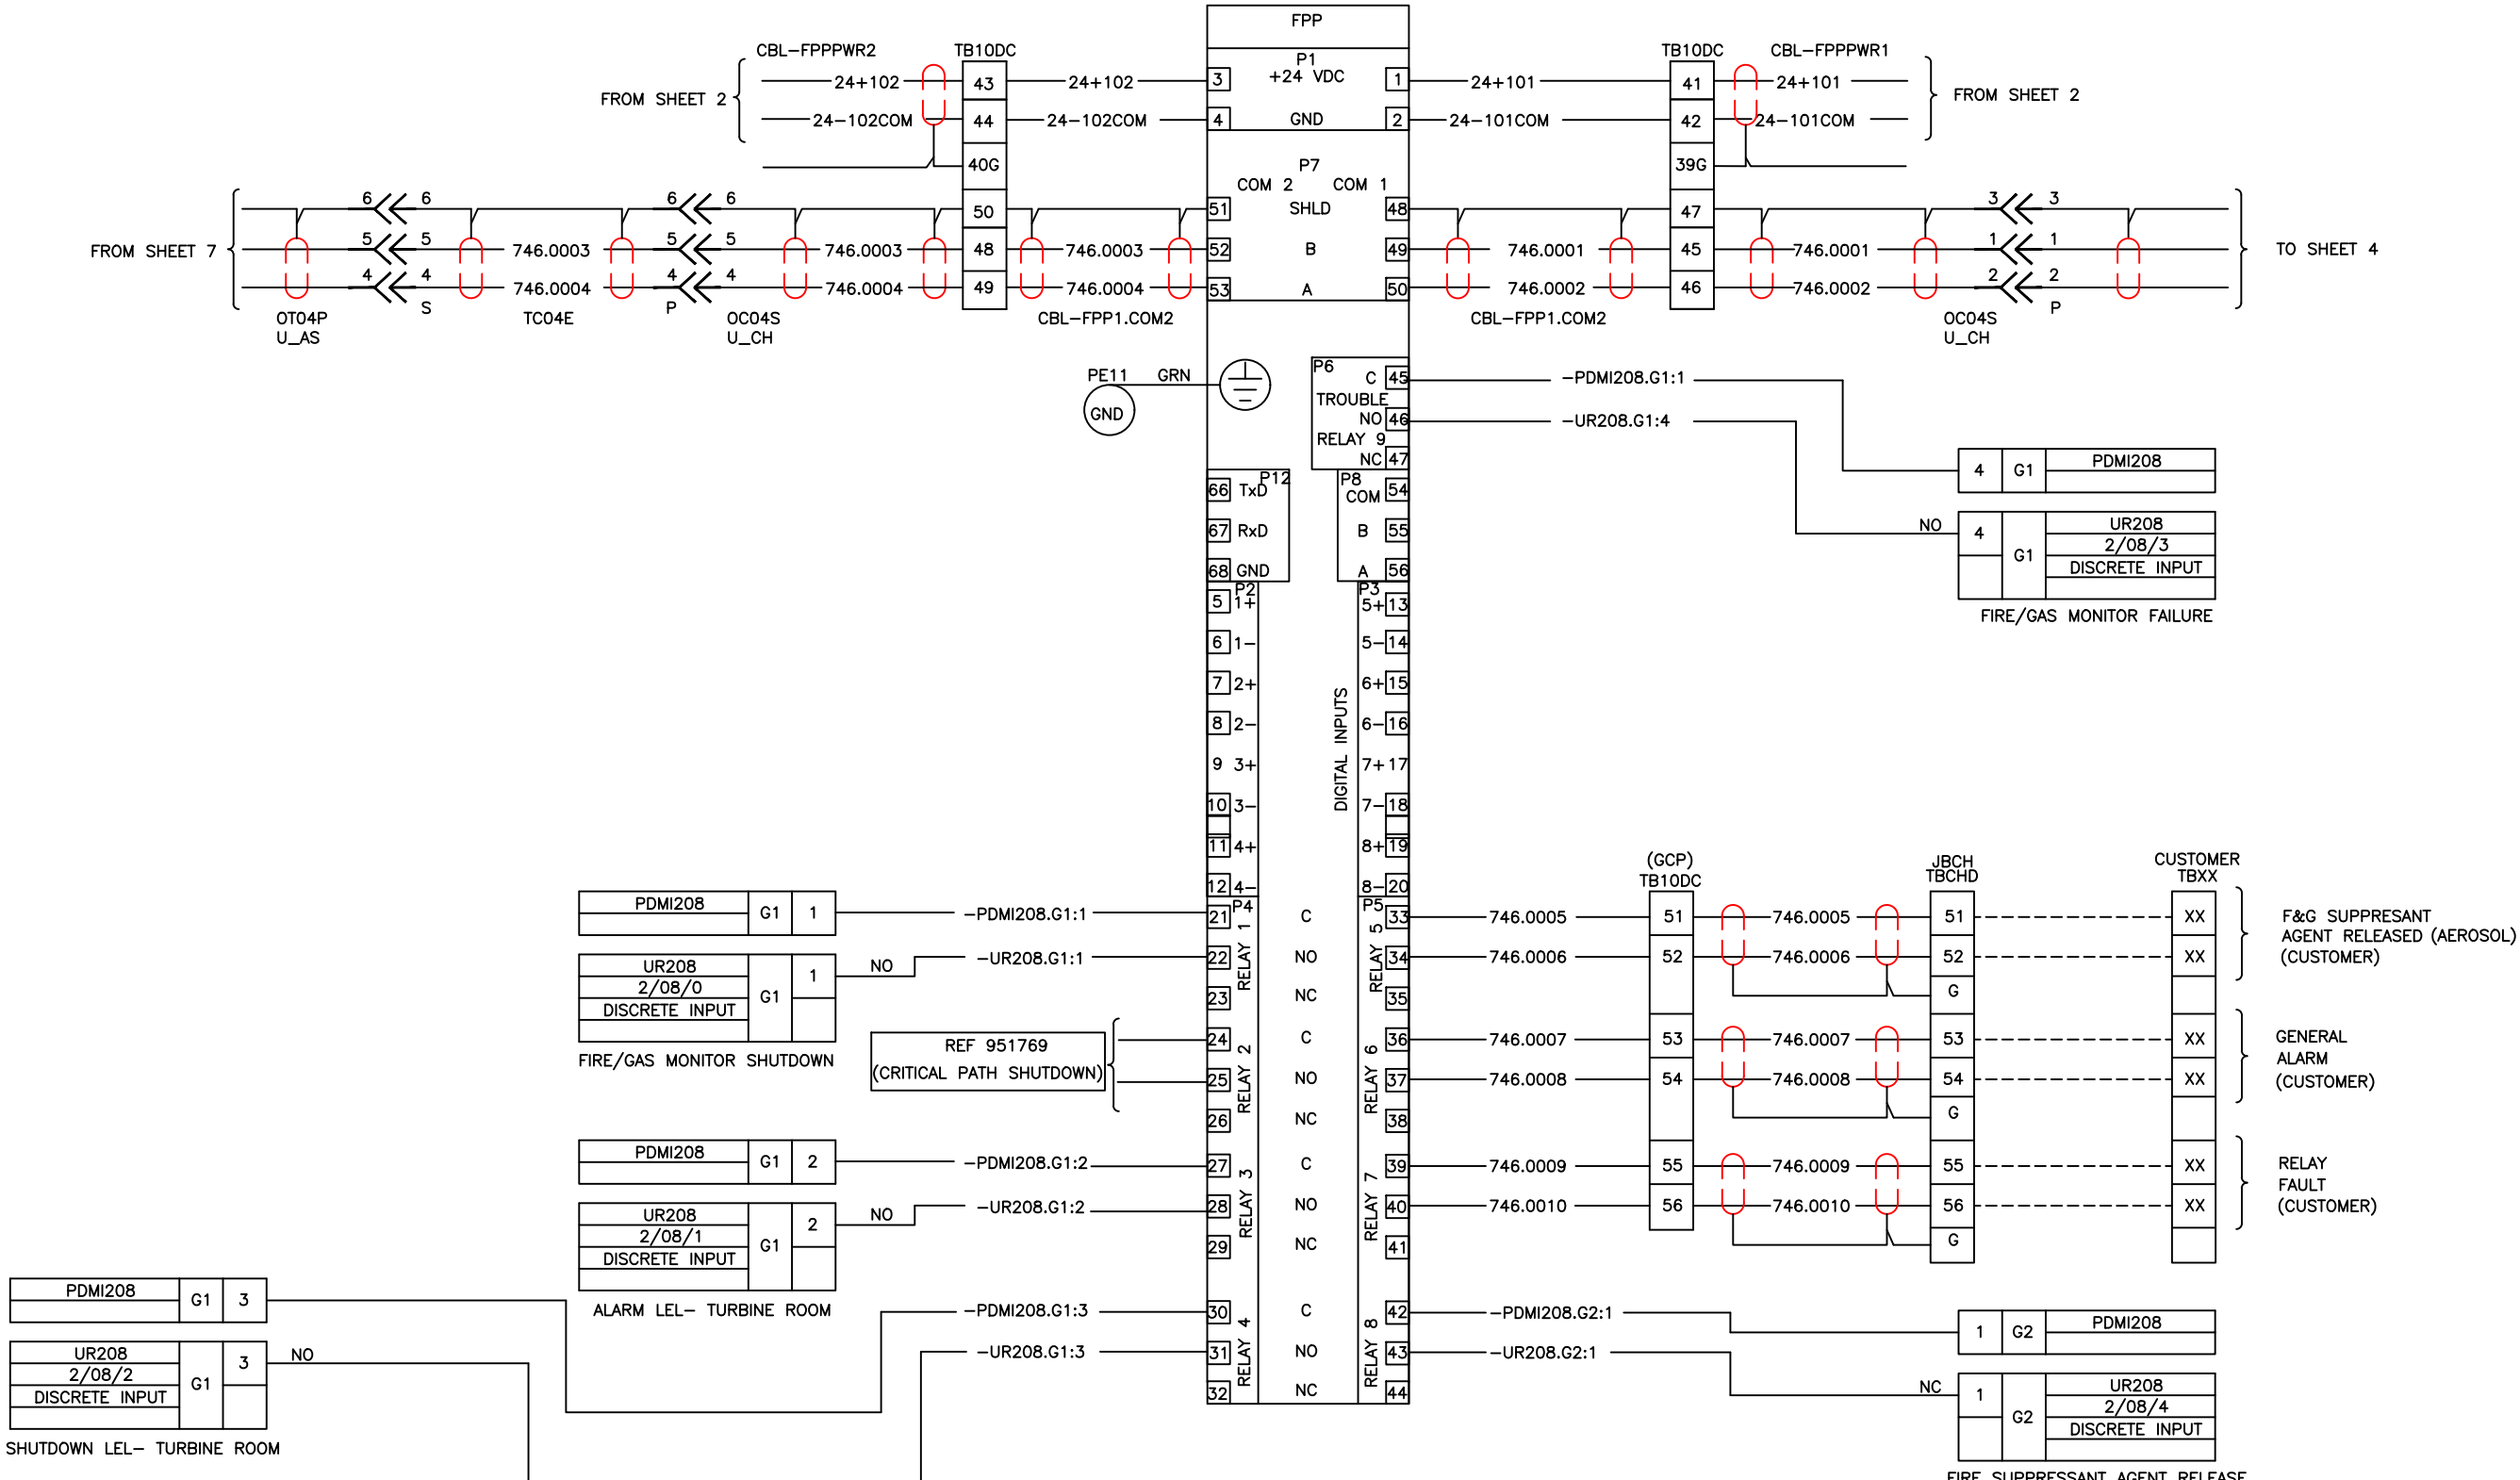[illegible]

THIS DRAWING, DESIGN AND THE DATA CONTAINED THEREIN IS THE PROPERTY OF WILSON FIRE EQUIPMENT AND IS NOT TO BE DISTRIBUTED TO OR USED BY OTHERS WITHOUT THE EXPRESSED WRITTEN CONSENT OF WILSON FIRE EQUIPMENT.		
SCALE:	AS SHOWN	DATE
DRAWN:	MP	07/13/20
CHECKED:	JV	09/10/20
APPROVED:	JV	09/10/20

WILSON FIRE EQUIPMENT & SERVICE CO.
7303 EMPIRE CENTRAL DRIVE HOUSTON, TEXAS 77040 (713) 896-4747

CUSTOMER INFORMATION


G.E. PACKAGED POWER L.P.

TM2500 GEN 9/ LM2500 XPRESS

CONTROLLER WIRING
FIRE & GAS DETECTION/
AEROSOL SUPPRESSION SYSTEM
WFE PROJECT # GE-MC



SIZE	DRAWING NO.	REV
B	SW-MC-03 SHEET 3 OF 9	B

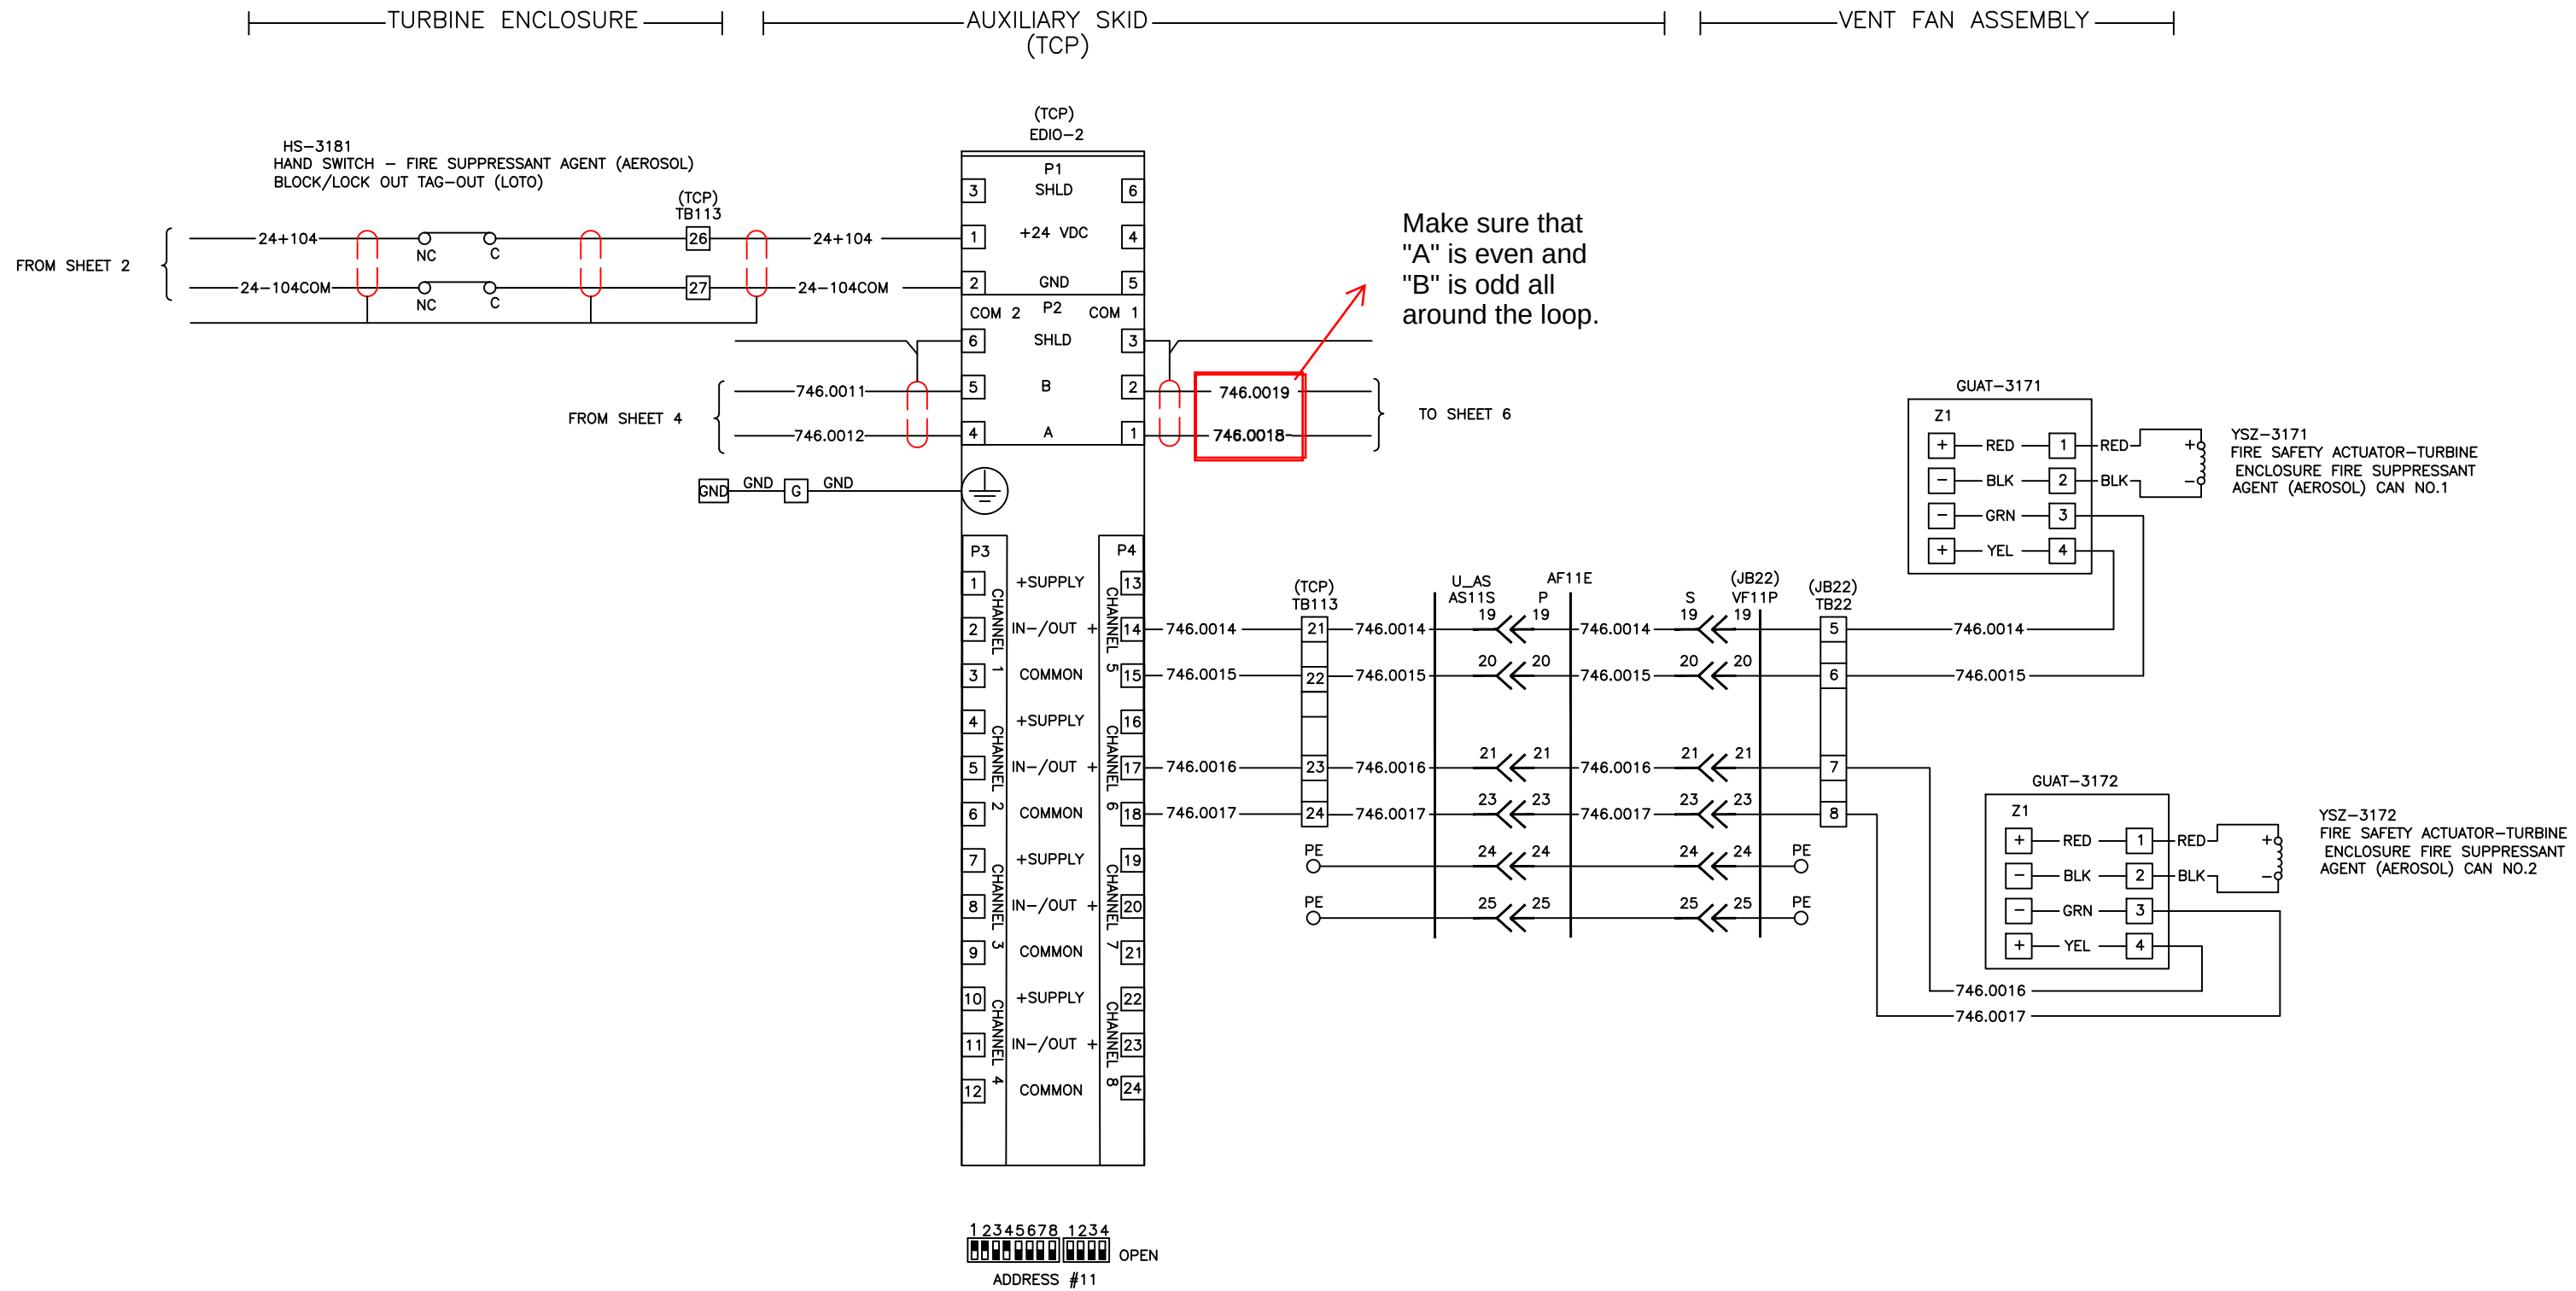

REVISIONS			
REV	DESCRIPTION	DATE	BY
A	ISSUED FOR APPROVAL	07/13/20	MP
B	REVISED PER CUSTOMER COMMENTS	09/10/20	MP

THIS DRAWING, DESIGN AND THE DATA CONTAINED THEREIN IS THE PROPERTY OF WILSON FIRE EQUIPMENT AND IS NOT TO BE DISTRIBUTED TO OR USED BY OTHERS WITHOUT THE EXPRESSED WRITTEN CONSENT OF WILSON FIRE EQUIPMENT.


SCALE: AS SHOWN DATE


DRAWN: MP 07/13/20

CHECKED: JV 09/10/20

APPROVED: JV 09/10/20

WILSON FIRE EQUIPMENT & SERVICE CO. 7303 EMPIRE CENTRAL DRIVE HOUSTON, TEXAS 77040 (713) 896-4747	
CUSTOMER INFORMATION	
G.E. PACKAGED POWER L.P.	
TM2500 GEN 9 / LM2500 XPRESS	
EDIO ELECTRICAL FIRE & GAS DETECTION/ AEROSOL SUPPRESSION SYSTEM WFE PROJECT # GE-1319	

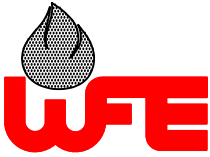		
SIZE	DRAWING NO.	REV
B	SW-MC-05 SHEET 5 OF 9	B

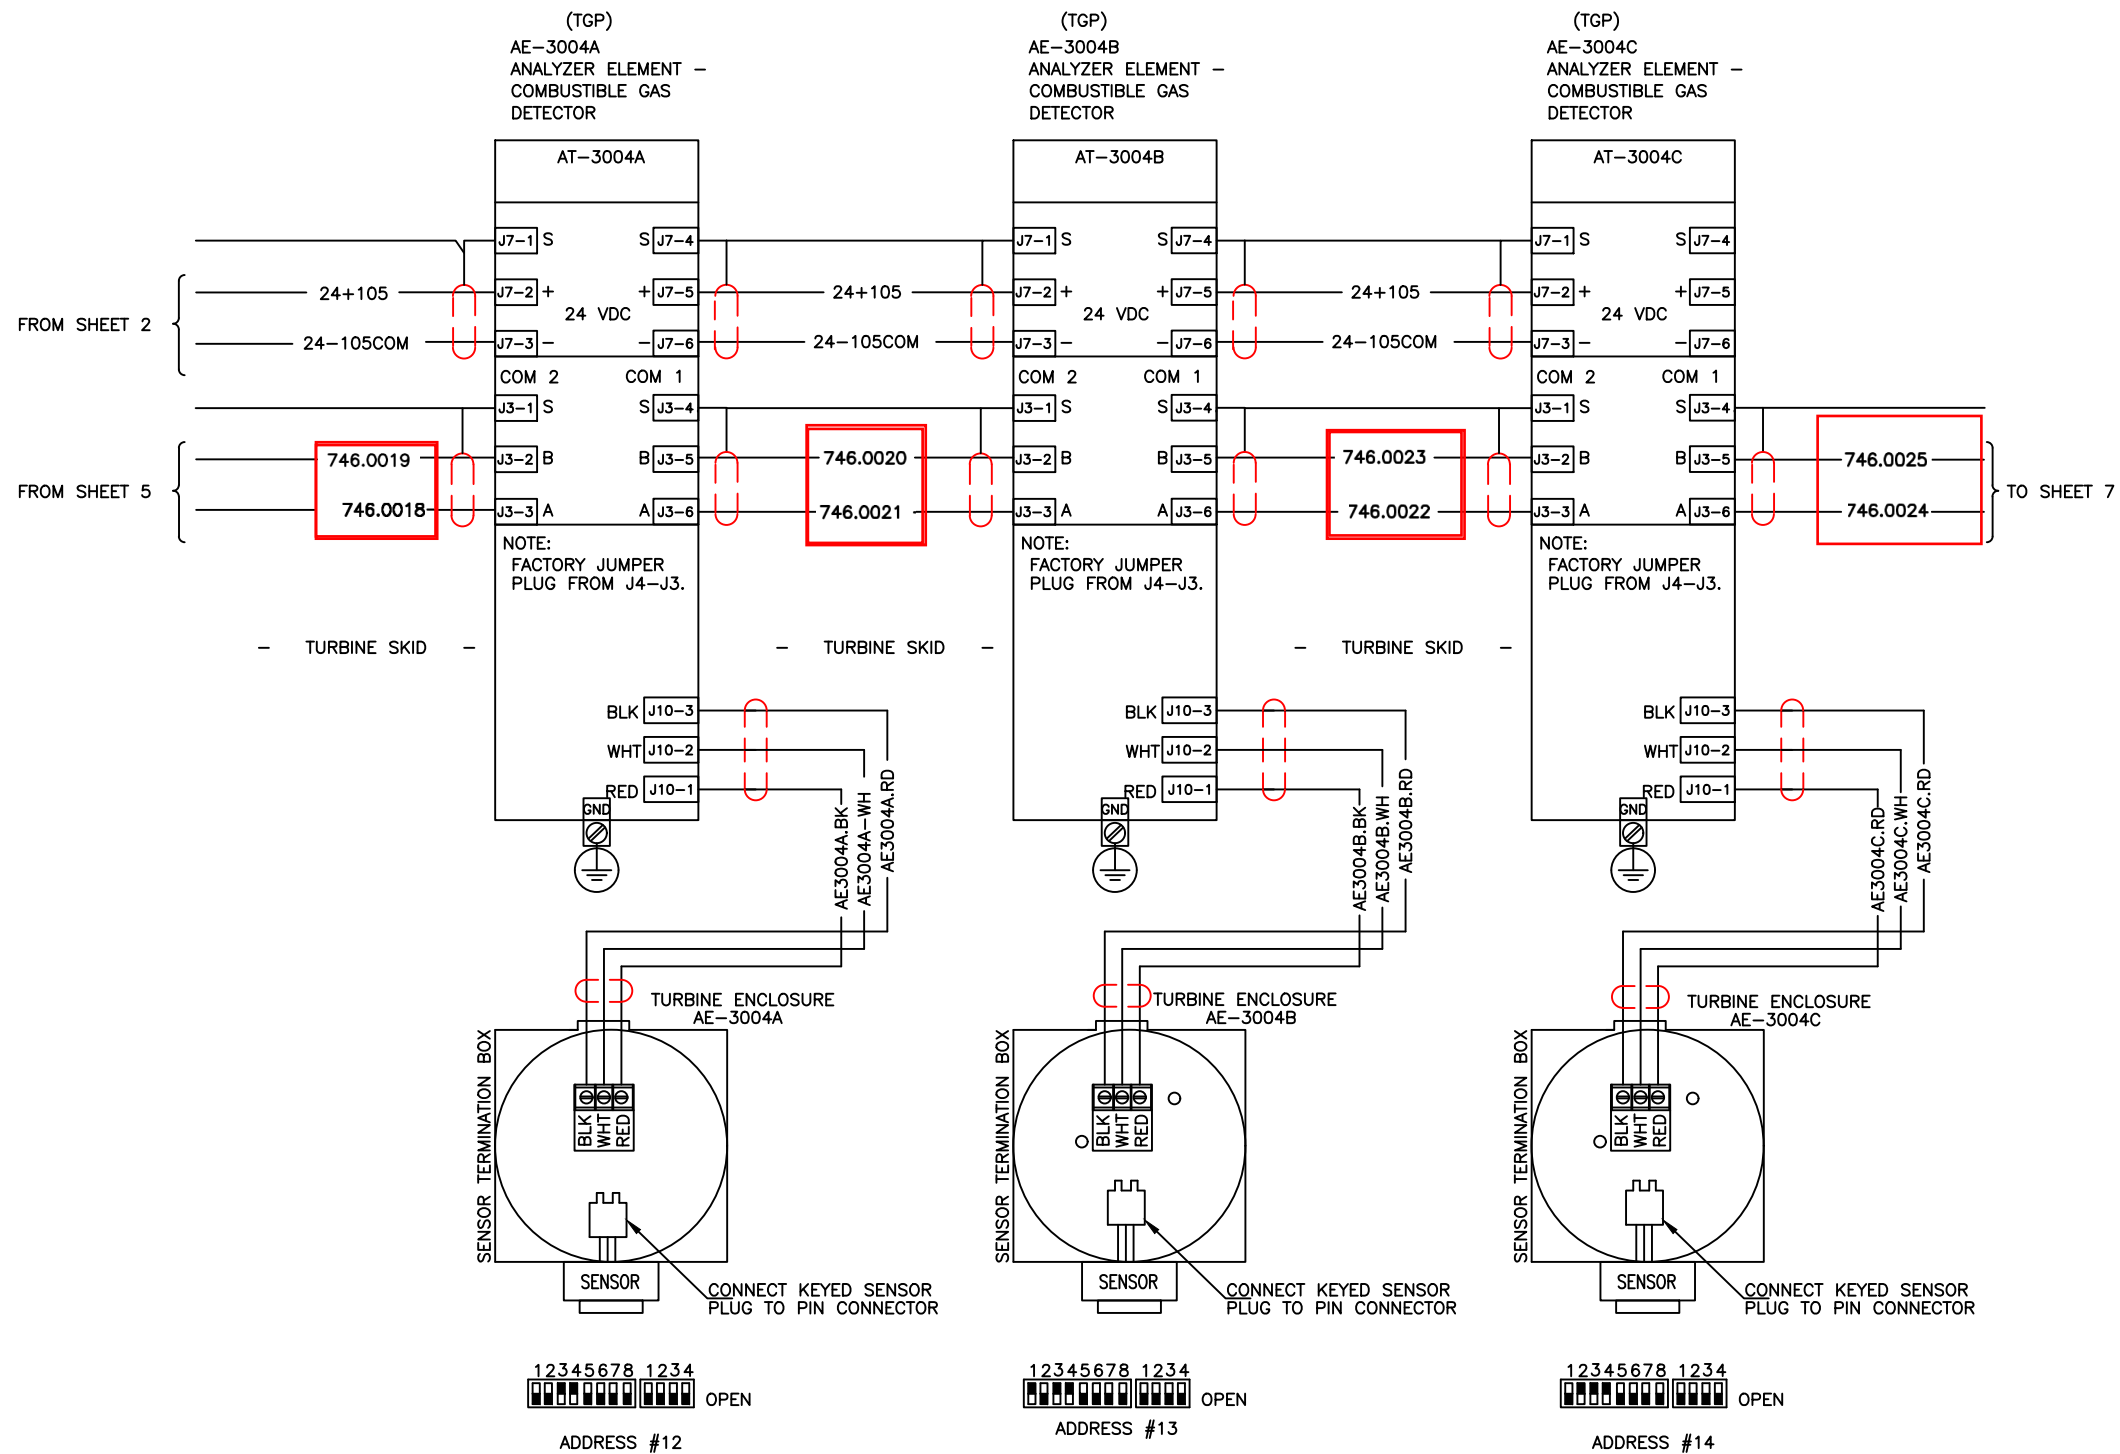

REVISIONS			
REV	DESCRIPTION	DATE	BY
A	ISSUED FOR APPROVAL	07/13/20	MP
B	REVISED PER CUSTOMER COMMENTS	09/10/20	MP

THIS DRAWING, DESIGN AND THE DATA CONTAINED THEREIN IS THE PROPERTY OF WILSON FIRE EQUIPMENT AND IS NOT TO BE DISTRIBUTED TO OR USED BY OTHERS WITHOUT THE EXPRESSED WRITTEN CONSENT OF WILSON FIRE EQUIPMENT.

SCALE:	AS SHOWN	DATE
DRAWN:	MP	07/13/20
CHECKED:	JV	09/10/20
APPROVED:	JV	09/10/20

WILSON FIRE EQUIPMENT & SERVICE CO. 7303 EMPIRE CENTRAL DRIVE HOUSTON, TEXAS 77040 (713) 896-4747	
CUSTOMER INFORMATION	
G.E. PACKAGED POWER L.P.	
TM2500 GEN 9 / LM2500 XPRESS	
LON LOOP FIRE & GAS DETECTION/ AEROSOL SUPPRESSION SYSTEM WFE PROJECT # GE-MC	

		
SIZE	DRAWING NO.	REV
B	SW-MC-06 SHEET 6 OF 9	B

NODE ADD	DEVICE TYPE	TAG NAME	DESCRIPTION	NODE CONFIGURATION SETTINGS											
1	CONTROLLER			CONFIG PORT BAUD RATE: 115200	PARITY: NONE	SERIAL PORT PROTOCOL:	MODBUS SLAVE	MODBUS BAUD RATE: 115200		PARITY: NONE		BEEPER VOLUME: HIGH	ALLOW LON POINT DISABLING: YES	OPTION CONTROL BOARD: NET:	CONTROL NET MAC ADDRESS:
	CONTROLLER INPUTS			INTPUT 1: NONE	INTPUT 2: NONE	INTPUT 3: NONE	INTPUT 4: NONE			INTPUT 5: NONE		INTPUT 6: NONE	INTPUT 7: NONE	INTPUT 8: NONE	
	CONTROLLER OUTPUTS			OUTPUT 1:	OUTPUT 2:	OUTPUT 3:	OUTPUT4:			OUTPUT 5:		OUTPUT 6	OUTPUT 7:	OUTPUT 8: NONE	
	RELAY-1		FIRE/GAS MONITOR SHUTDOWN												
	RELAY-2		CRITICAL PATH SHUTDOWN												
	RELAY-3		ALARM LEL- TURBINE ROOM												
	RELAY-4		SHUTDOWN LEL- TURBINE ROOM												
	RELAY-5		F&G SUPPRESANT AGENT RELEASE (CUSTOMER)												
	RELAY-6		GENERAL ALARM (CUSTOMER)												
	RELAY-7		RELAY FAULT (CUSTOMER)												
	RELAY-8		AEROSOL DISCHARGE SIGNAL												

NODE ADD	DEVICE TYPE	TAG NAME	DESCRIPTION	NODE CONFIGURATION SETTINGS										
10	EDIO-01	EDIO-01								12345678 #10 OPEN				
	CH 1	JB18-1	HS-3093, 3092 HAND SWITCH-MANUAL RELEASE	CHANNEL TYPE: INPUT	SUPERVISION: OPENS	STATIC LOGIC FIRE MODE (INPUT): ALARM	ACTIVATION TIME (INPUT): 0 SEC.							
	CH 2	JB18-2	YSA-3006B HORN (OUTSIDE TURBINE ENCLOSURE)	CHANNEL TYPE: OUTPUT	SUPERVISION: OPENS	STATIC LOGIC MODE (INPUT): SUPERVISORY	ACTIVATION TIME (INPUT): CONTINUOUS							
	CH 3	JB18-3	YSA-3006A HORN (INSIDE TURBINE ENCLOSURE)	CHANNEL TYPE: OUTPUT	SUPERVISION: OPENS	STATIC LOGIC MODE (INPUT): SUPERVISORY	ACTIVATION TIME (INPUT): CONTINUOUS							
	CH 4	JB18-4	TS-3003, 3014 THERMAL DETECTOR (TURBINE ENCLOSURE)	CHANNEL TYPE: INPUT	SUPERVISION: OPENS	STATIC LOGIC FIRE MODE (INPUT): ALARM	ACTIVATION TIME (INPUT): 0 SEC.							
	CH 5	JB18-5	YSL-3041 BEACON (OUTSIDE TURBINE ENCLOSURE)	CHANNEL TYPE: OUTPUT	SUPERVISION: OPENS	STATIC LOGIC MODE (INPUT): SUPERVISORY	ACTIVATION TIME (INPUT): CONTINUOUS							
	CH 6	JB18-6	YSL-3042 BEACON (OUTSIDE TURBINE ENCLOSURE)	CHANNEL TYPE: OUTPUT	SUPERVISION: OPENS	STATIC LOGIC MODE (INPUT): SUPERVISORY	ACTIVATION TIME (INPUT): CONTINUOUS							
	CH 7	JB18-7	YSL-3036 BEACON (INSIDE TURBINE ENCLOSURE)	CHANNEL TYPE: OUTPUT	SUPERVISION: OPENS	STATIC LOGIC MODE (INPUT): SUPERVISORY	ACTIVATION TIME (INPUT): CONTINUOUS							
	CH 8	JB18-8	HS-3040 HORN ACKNOWLEDGE (TURBINE ENCLOSURE)	CHANNEL TYPE: INPUT	SUPERVISION: OPENS	STATIC LOGIC MODE (INPUT): SUPERVISORY	ACTIVATION TIME (INPUT): 0 SEC.							

REVISIONS			
REV	DESCRIPTION	DATE	BY
A	ISSUED FOR APPROVAL	07/13/20	MP
B	REVISED PER CUSTOMER COMMENTS	09/11/20	MP

THIS DRAWING, DESIGN AND THE DATA CONTAINED THEREIN IS THE PROPERTY OF WILSON FIRE EQUIPMENT AND IS NOT TO BE DISTRIBUTED TO OR USED BY OTHERS WITHOUT THE EXPRESSED WRITTEN CONSENT OF WILSON FIRE EQUIPMENT.

SCALE:	AS SHOWN	DATE
DRAWN:	MP	07/13/20
CHECKED:	JV	09/11/20
APPROVED:	JV	09/11/20

WILSON FIRE EQUIPMENT & SERVICE CO.
7303 EMPIRE CENTRAL DRIVE HOUSTON, TEXAS 77040 (713) 896-4747

CUSTOMER INFORMATION

G.E. PACKAGED POWER L.P.

TM2500 GEN 9 / LM2500 XPRESS

LON LIST
FIRE & GAS DETECTION/
AEROSOL SUPPRESSION SYSTEM
WFE PROJECT # GE-MC



SIZE	DRAWING NO.	REV
B	SW-MC-08 SHEET 8 OF 9	B

NODE ADD	DEVICE TYPE	TAG NAME	DESCRIPTION	NODE CONFIGURATION SETTINGS											
11	EDIO-02	EDIO-02									12345678 #11 00000000 OPEN				
	CH 1	JB18-1													
	CH 2	JB18-2													
	CH 3	JB18-3													
	CH 4	JB18-4													
	CH 5	JB18-5	YSZ-3171 AEROSOL FIRE SUPPRESSANT (TURBINE)	CHANNEL TYPE: OUTPUT	SUPERVISION: OPENS	STATIC LOGIC MODE (INPUT): SUPERVISORY	ACTIVATION TIME (INPUT): CONTINUOUS								
	CH 6	JB18-6	YSZ-3172 AEROSOL FIRE SUPPRESSANT (TURBINE)	CHANNEL TYPE: OUTPUT	SUPERVISION: OPENS	STATIC LOGIC MODE (INPUT): SUPERVISORY	ACTIVATION TIME (INPUT): CONTINUOUS								
	CH 7	JB18-7													
	CH 8	JB18-8													

NODE ADD	DEVICE TYPE	TAG NAME	DESCRIPTION	NODE CONFIGURATION SETTINGS											
12	UD10-DCU	AE-3004A	AE-3004A ANALYZER ELEMENT COMBUSTIBLE GAS DETECTOR	DCU TYPE: EXPLOSIVE	HIGH ALARM: 25	LOW ALARM: 15	CAL LEVEL: 50	GAS MODE: GAS DETECTOR			12345678 #12 00000000 OPEN				DEADBAND 5
13	UD10-DCU	AE-3004B	AE-3004B ANALYZER ELEMENT COMBUSTIBLE GAS DETECTOR	DCU TYPE: EXPLOSIVE	HIGH ALARM: 25	LOW ALARM: 15	CAL LEVEL: 50	GAS MODE: GAS DETECTOR			12345678 #13 00000000 OPEN				DEADBAND 5
14	UD10-DCU	AE-3004C	AE-3004C ANALYZER ELEMENT COMBUSTIBLE GAS DETECTOR	DCU TYPE: EXPLOSIVE	HIGH ALARM: 25	LOW ALARM: 15	CAL LEVEL: 50	GAS MODE: GAS DETECTOR			12345678 #14 00000000 OPEN				DEADBAND 5
15	ECLIPSE	AE-3029	AE-3029 ANALYZER ELEMENT IR GAS DETECTOR	GAS TYPE: METHANE	CAL GAS TYPE: METHANE	CAL METHOD: STD	UNITS: 50% LFL	HIGH ALARM: 10	LOW ALARM: 5		12345678 #15 00000000 OPEN				DEADBAND 5
16	ECLIPSE	AE-3030	AE-3030 ANALYZER ELEMENT IR GAS DETECTOR	GAS TYPE: METHANE	CAL GAS TYPE: METHANE	CAL METHOD: STD	UNITS: 50% LFL	HIGH ALARM: 10	LOW ALARM: 5		12345678 #16 00000000 OPEN				DEADBAND 5

REVISIONS			
REV	DESCRIPTION	DATE	BY
A	ISSUED FOR APPROVAL	07/13/20	MP
B	REVISED PER CUSTOMER COMMENTS	09/10/20	MP

THIS DRAWING, DESIGN AND THE DATA CONTAINED THEREIN IS THE PROPERTY OF WILSON FIRE EQUIPMENT AND IS NOT TO BE DISTRIBUTED TO OR USED BY OTHERS WITHOUT THE EXPRESSED WRITTEN CONSENT OF WILSON FIRE EQUIPMENT.

SCALE:	AS SHOWN	DATE
DRAWN:	MP	07/13/20
CHECKED:	JV	09/10/20
APPROVED:	JV	09/10/20

WILSON FIRE EQUIPMENT & SERVICE CO.
7303 EMPIRE CENTRAL DRIVE HOUSTON, TEXAS 77040 (713) 896-4747

CUSTOMER INFORMATION

G.E. PACKAGED POWER L.P.

TM2500 GEN 9 / LM2500 XPRESS

LON LIST
FIRE & GAS DETECTION /
AEROSOL SUPPRESSION SYSTEM
WFE PROJECT # GE-MC



SIZE	DRAWING NO.	REV
B	SW-MC-09 SHEET 9 OF 9	B