


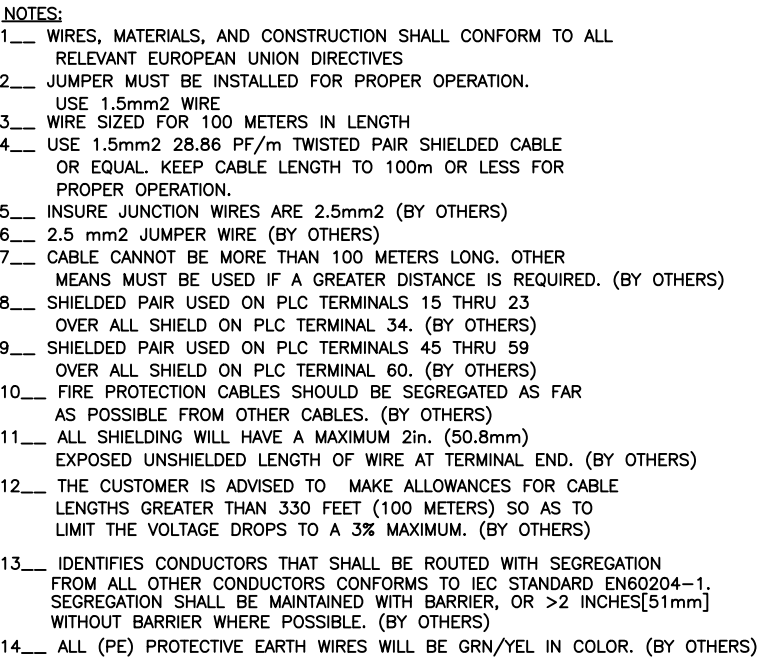

WIRE GAUGE CONVERSION TABLE (AMERICAN WIRE GAUGE—METRIC)

US Standard AWG	NEAREST AVAILABLE CROSS-SECTION mm ²
22	0.5
18	0.75
16	1.5
14	2.5
12	4.0
10	6.0
8	10.0
6	16.0
4	25.0
2	35.0

[illegible]

THIS DRAWING, DESIGN AND THE DATA
CONTAINED THEREIN IS THE PROPERTY
OF WILSON FIRE EQUIPMENT AND IS
NOT TO BE DISTRIBUTED TO OR USED
BY OTHERS WITHOUT THE EXPRESSED
WRITTEN CONSENT OF WILSON
FIRE EQUIPMENT.

SCALE:	AS SHOWN	DATE
DRAWN:	MP	07/13/20
CHECKED:	JV	07/13/20
APPROVED:	JV	07/13/20

WILSON FIRE EQUIPMENT & SERVICE CO.
7303 EMPIRE CENTRAL DRIVE HOUSTON, TEXAS 77040 (713) 896-4747

CUSTOMER INFORMATION

GEN 9

LM2500 XPRESS


CUSTOMER INTERCONNECT WIRING
FIRE & GAS DETECTION/
AEROSOL SUPPRESSION SYSTEM
WFE PROJECT # GE-MC



SIZE	DRAWING NO.	REV
B	IW-MC-01 SHEET 1 OF 1	A

LEGEND:
SEE 000005

- NOTE:
- 1. APPLICABLE STANDARD/SPECIFICATION:
IEEE 315–1975 GRAPHIC SYMBOLS FOR ELECTRICAL AND ELECTRONIC DIAGRAMS.
 - 2. ALL DEVICES SHOWN DE–ENERGIZED (SHELF STATE).
 - 3. NX XX REPRESENTS NODE NUMBER IN DISTRIBUTION I/O NETWORK:

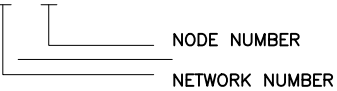

- 4. CUSTOMER DRAWING NUMBERS CONSIST OF: (ORDER NUMBER)–(STANDARD DRAWING NUMBER), AD ARE REFERENCED AS X–(STANDARD DRAWING NUMBER), WHERE X = ORDER NUMBER.

5. RESERVED FOR PROPANE OPTION FOR CUSTOMER REFER 851996G000X

- REFERENCE DRAWINGS:
- 000005 ELECTRICAL SYMBOLS, ABBREVIATIONS AND REFERENCE DATA
 - 851767 SCHEMATIC DIAGRAM, DC POWER DISTRIBUTION
 - 851768 SCHEMATIC DIAGRAM, CRITICAL SHUTDOWN PATH
 - 851934 SYSTEM SCHEMATIC, COMMUNICATION
 - ~~8511996GXXXX FIELD MODIFICATION RETROFIT KIT PROPANE HD–5~~

REVISIONS			
REV	DESCRIPTION	DATE	BY
A	ISSUED FOR APPROVAL	07/13/20	MP

THIS DRAWING, DESIGN AND THE DATA CONTAINED THEREIN IS THE PROPERTY OF WILSON FIRE EQUIPMENT AND IS NOT TO BE DISTRIBUTED TO OR USED BY OTHERS WITHOUT THE EXPRESSED WRITTEN CONSENT OF WILSON FIRE EQUIPMENT.

SCALE:	AS SHOWN	DATE
DRAWN:	MP	07/13/20
CHECKED:	JV	07/13/20
APPROVED:	JV	07/13/20

WILSON FIRE EQUIPMENT & SERVICE CO.
7303 EMPIRE CENTRAL DRIVE HOUSTON, TEXAS 77040 (713) 896–4747

CUSTOMER INFORMATION

GEN 9


LM2500 XPRESS

SYSTEM WIRING LEGEND
FIRE & GAS DETECTION/
AEROSOL SUPPRESSION SYSTEM
WFE PROJECT # GE–MC



SIZE	DRAWING NO.	REV
B	SW–MC–01 SHEET 1 OF 9	A

CONTROL HOUSE
GENERATOR CONTROL PANEL (GCP)

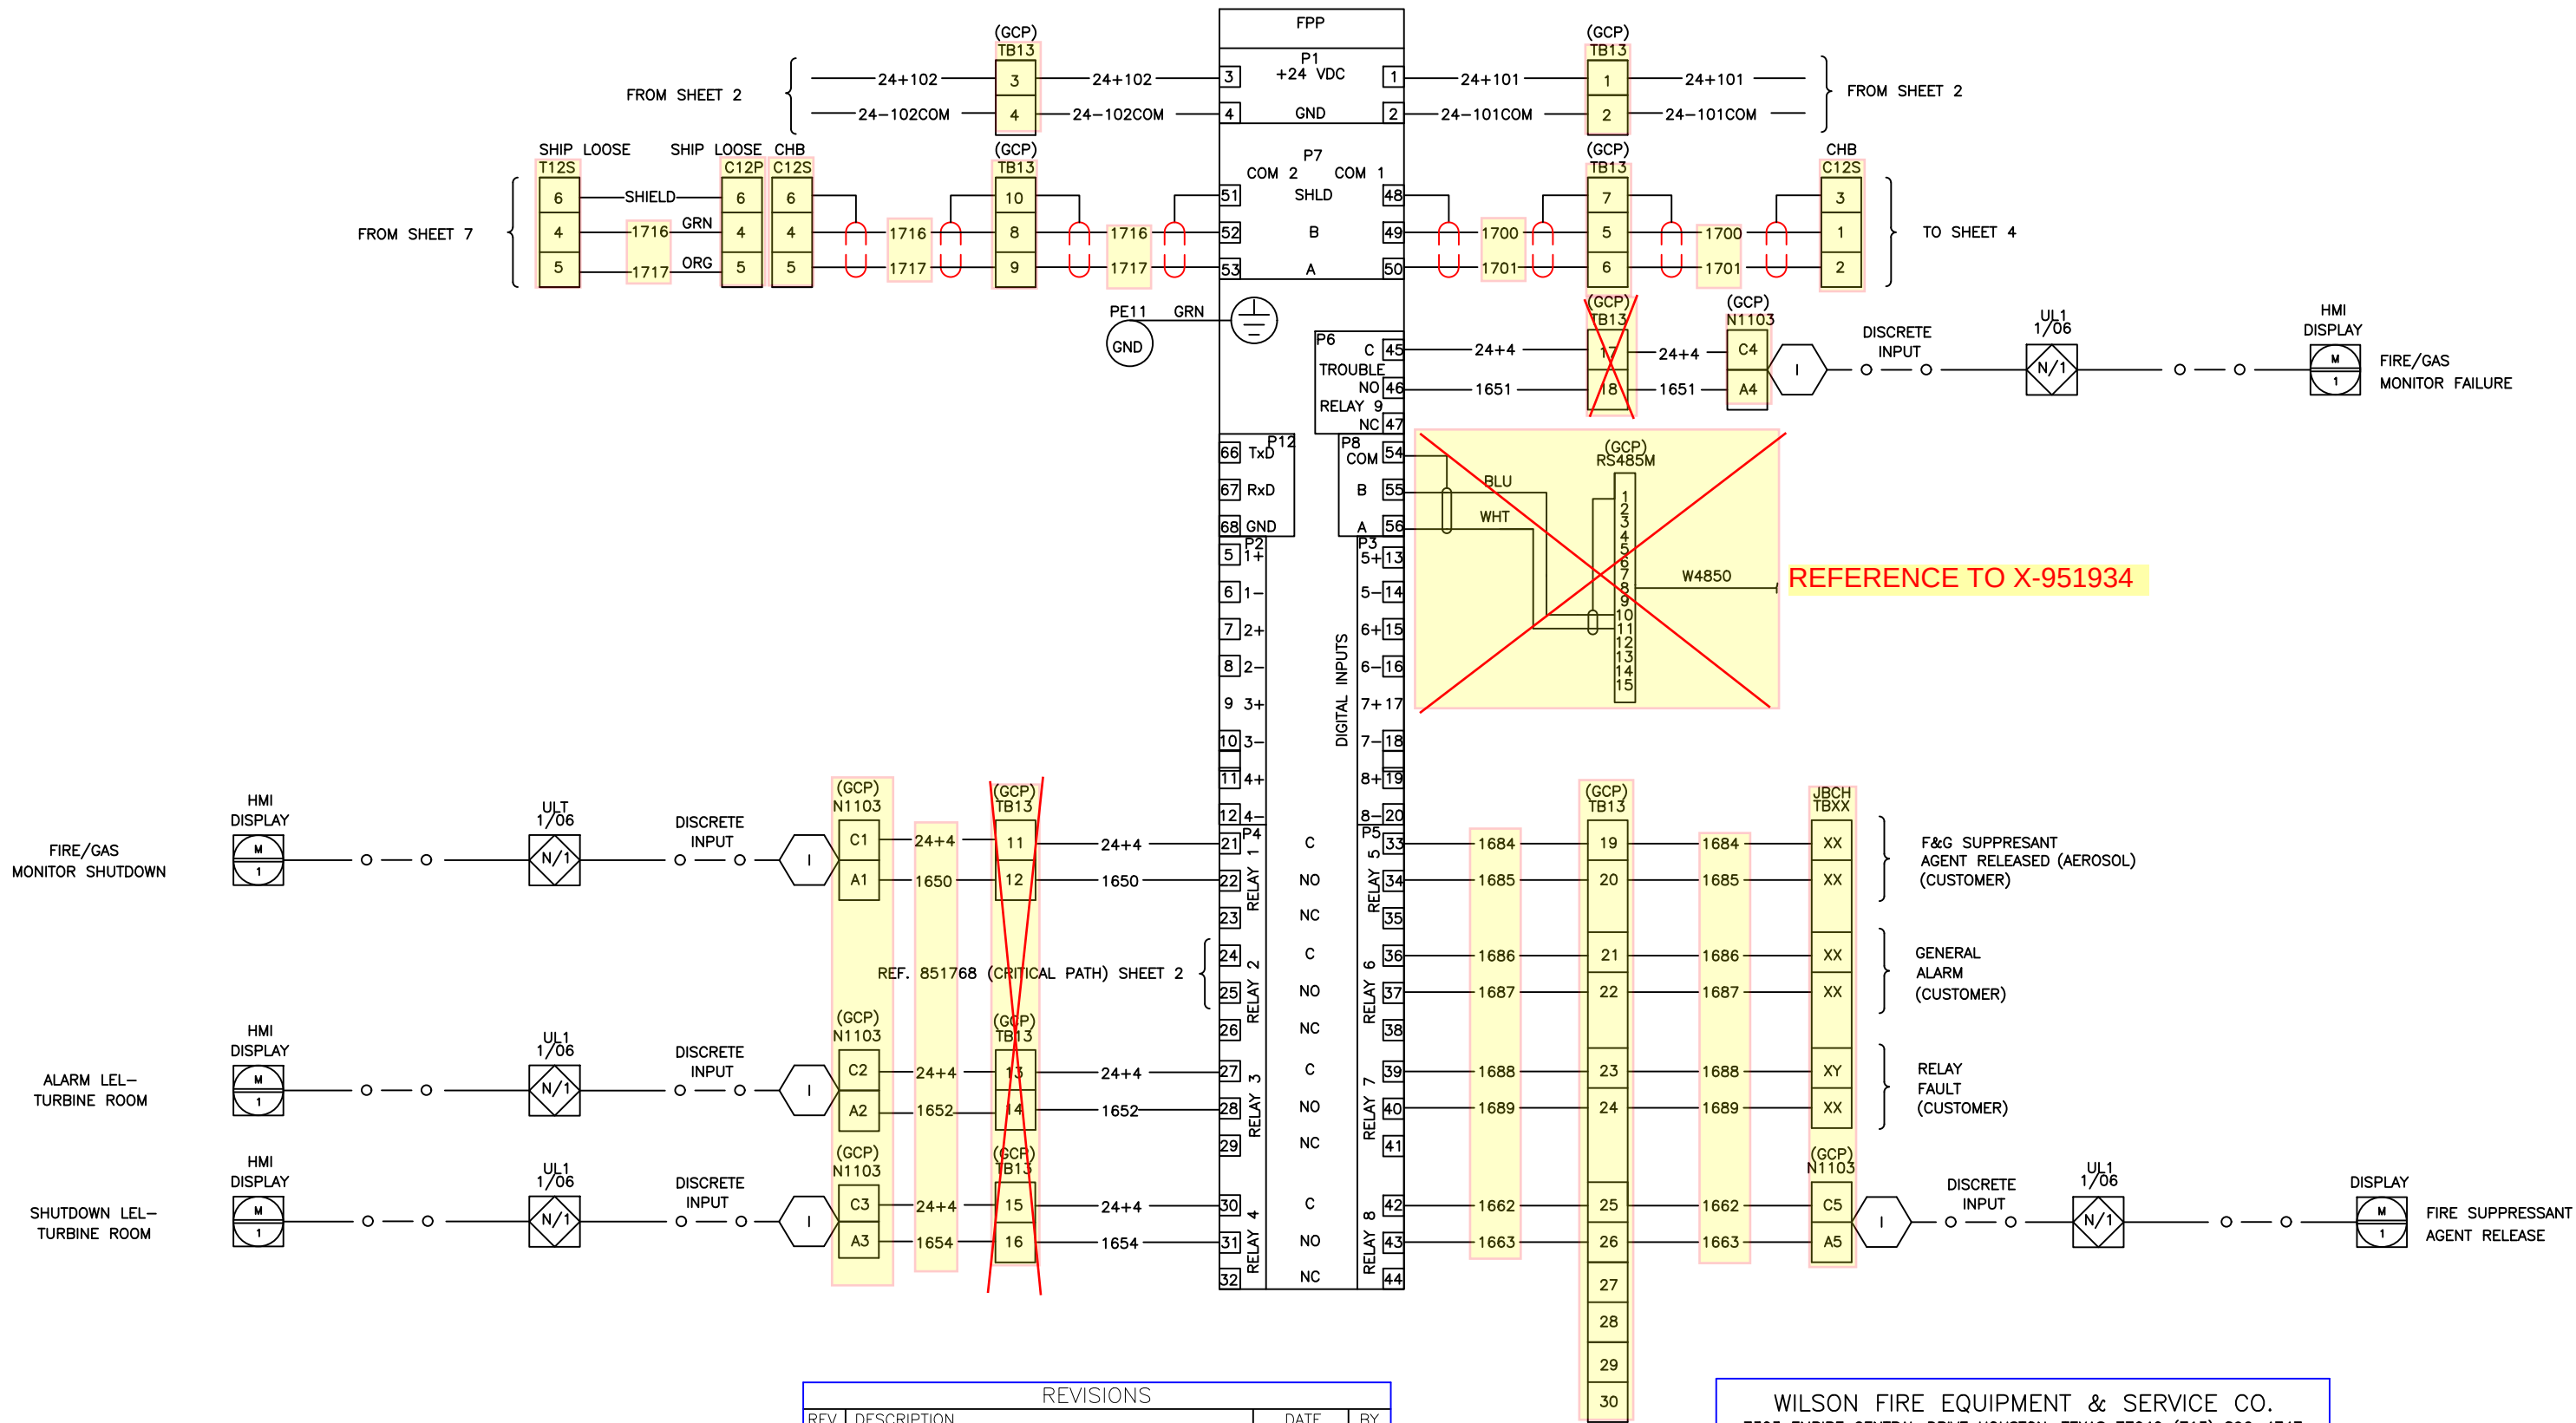

REVISIONS			
REV	DESCRIPTION	DATE	BY
A	ISSUED FOR APPROVAL	07/13/20	MP

THIS DRAWING, DESIGN AND THE DATA CONTAINED THEREIN IS THE PROPERTY OF WILSON FIRE EQUIPMENT AND IS NOT TO BE DISTRIBUTED TO OR USED BY OTHERS WITHOUT THE EXPRESSED WRITTEN CONSENT OF WILSON FIRE EQUIPMENT.

SCALE: AS SHOWN DATE


DRAWN: MP 07/13/20

CHECKED: JV 07/13/20


APPROVED: JV 07/13/20

WILSON FIRE EQUIPMENT & SERVICE CO.	
7303 EMPIRE CENTRAL DRIVE HOUSTON, TEXAS 77040 (713) 896-4747	
CUSTOMER INFORMATION	
GEN 9	
LM2500 XPRESS	
CONTROLLER WIRING FIRE & GAS DETECTION/ AEROSOL SUPPRESSION SYSTEM WFE PROJECT # GE-MC	

WFE		
SIZE	DRAWING NO.	REV
B	SW-MC-03 SHEET 3 OF 9	A

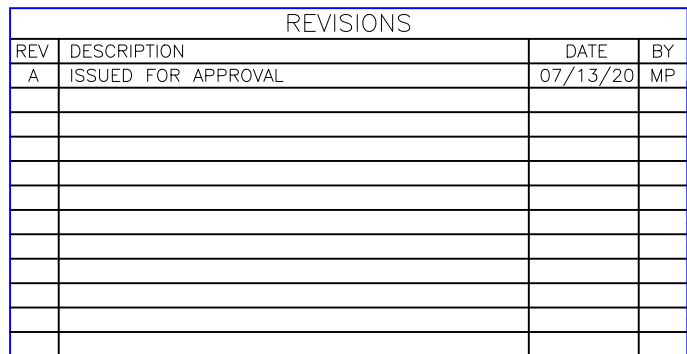

	TURBINE	SKID	
--	---------	------	--

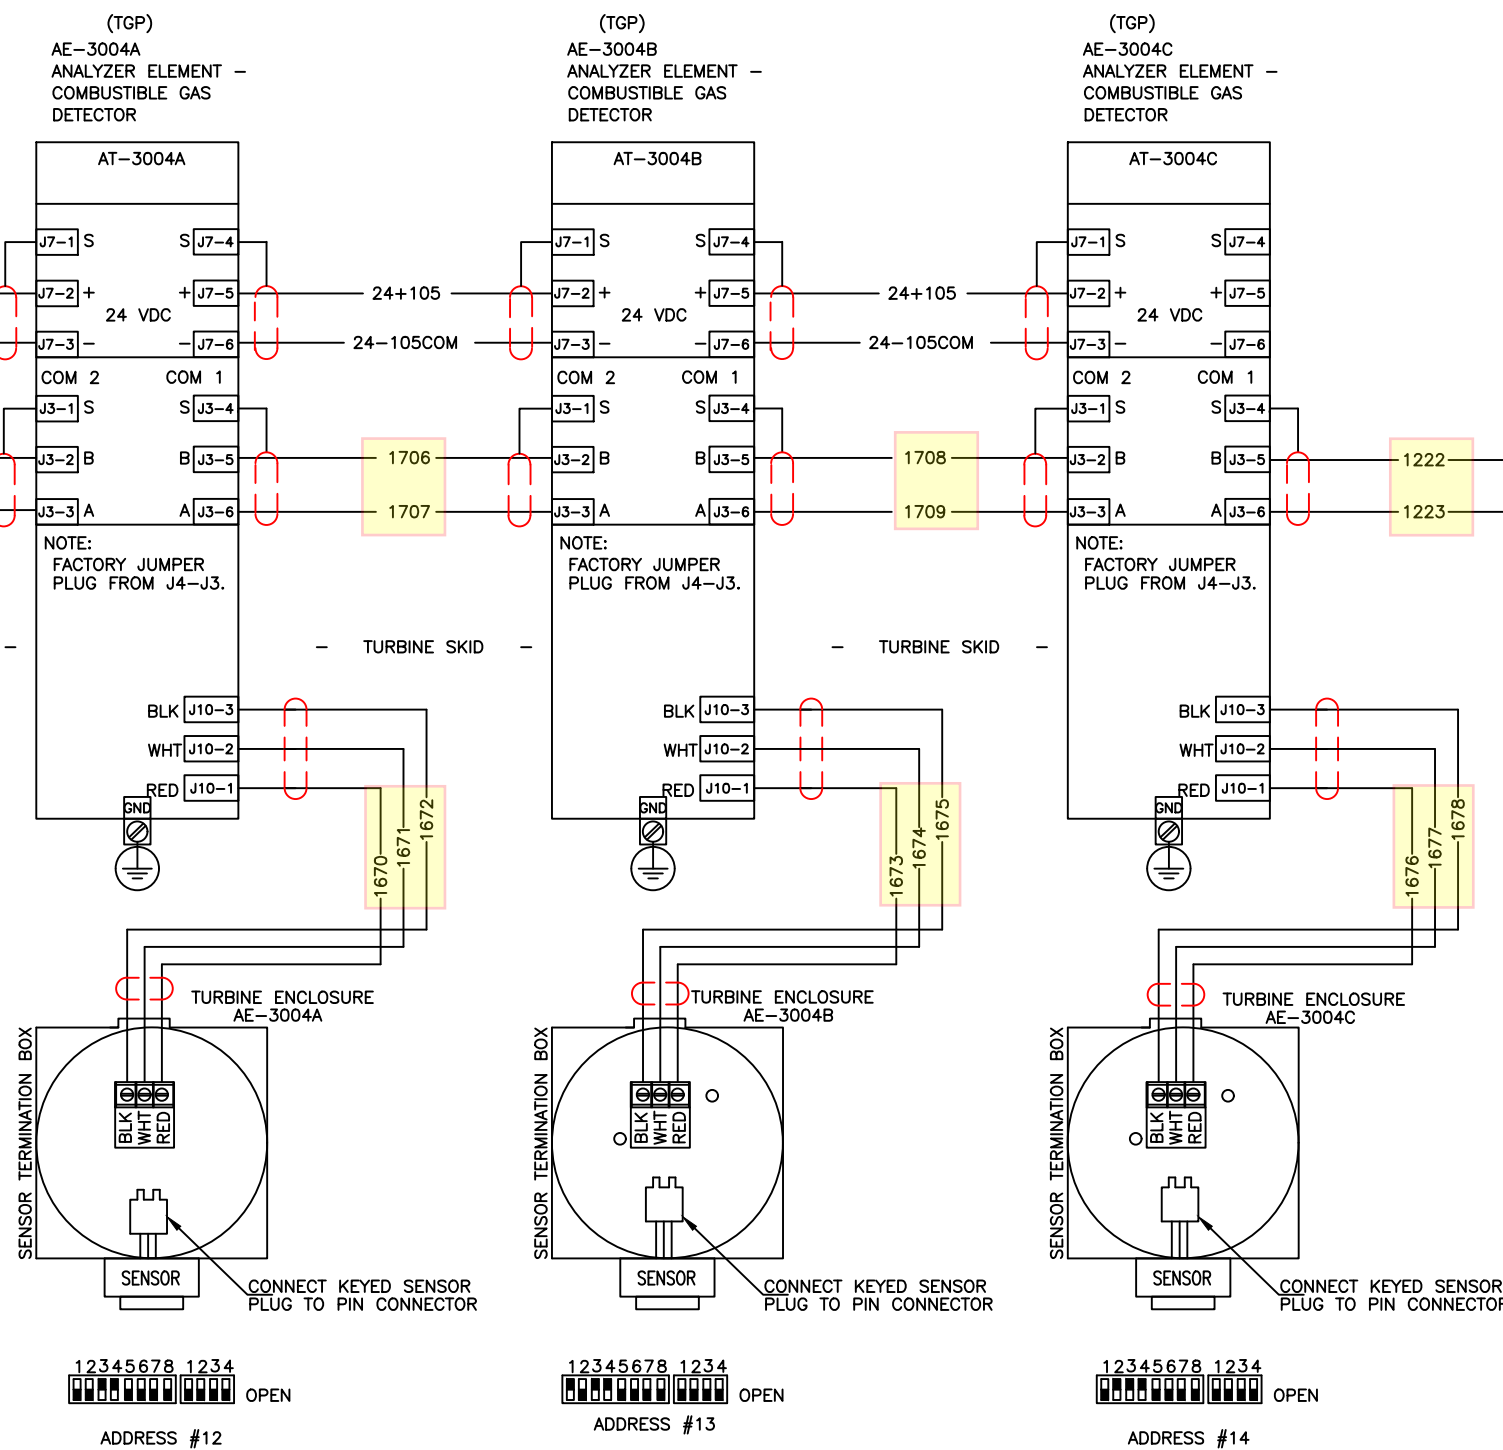[illegible]

THIS DRAWING, DESIGN AND THE DATA CONTAINED THEREIN IS THE PROPERTY OF WILSON FIRE EQUIPMENT AND IS NOT TO BE DISTRIBUTED TO OR USED BY OTHERS WITHOUT THE EXPRESSED WRITTEN CONSENT OF WILSON FIRE EQUIPMENT.

SCALE:	AS SHOWN	DATE
DRAWN:	MP	07/13/2
CHECKED:	JV	07/13/2
APPROVED:	JV	07/13/2


WILSON FIRE EQUIPMENT & SERVICE CO. 7303 EMPIRE CENTRAL DRIVE HOUSTON, TEXAS 77040 (713) 896-4747	
CUSTOMER	INFORMATION
GEN 9 LM2500 XPRESS	
LON LOOP FIRE & GAS DETECTION/ AEROSOL SUPPRESSION SYSTEM WFE PROJECT # GE-MC	



SIZE	DRAWING NO.	REV
B	SW-MC-06 SHEET 6 OF 9	A

TURBINE ENCLOSURE

Gas detectors are located now into Exhaust skid that is removable when shipping so both sensors need to be connected into separated JB38, then with interconnection, signal goes to JB22

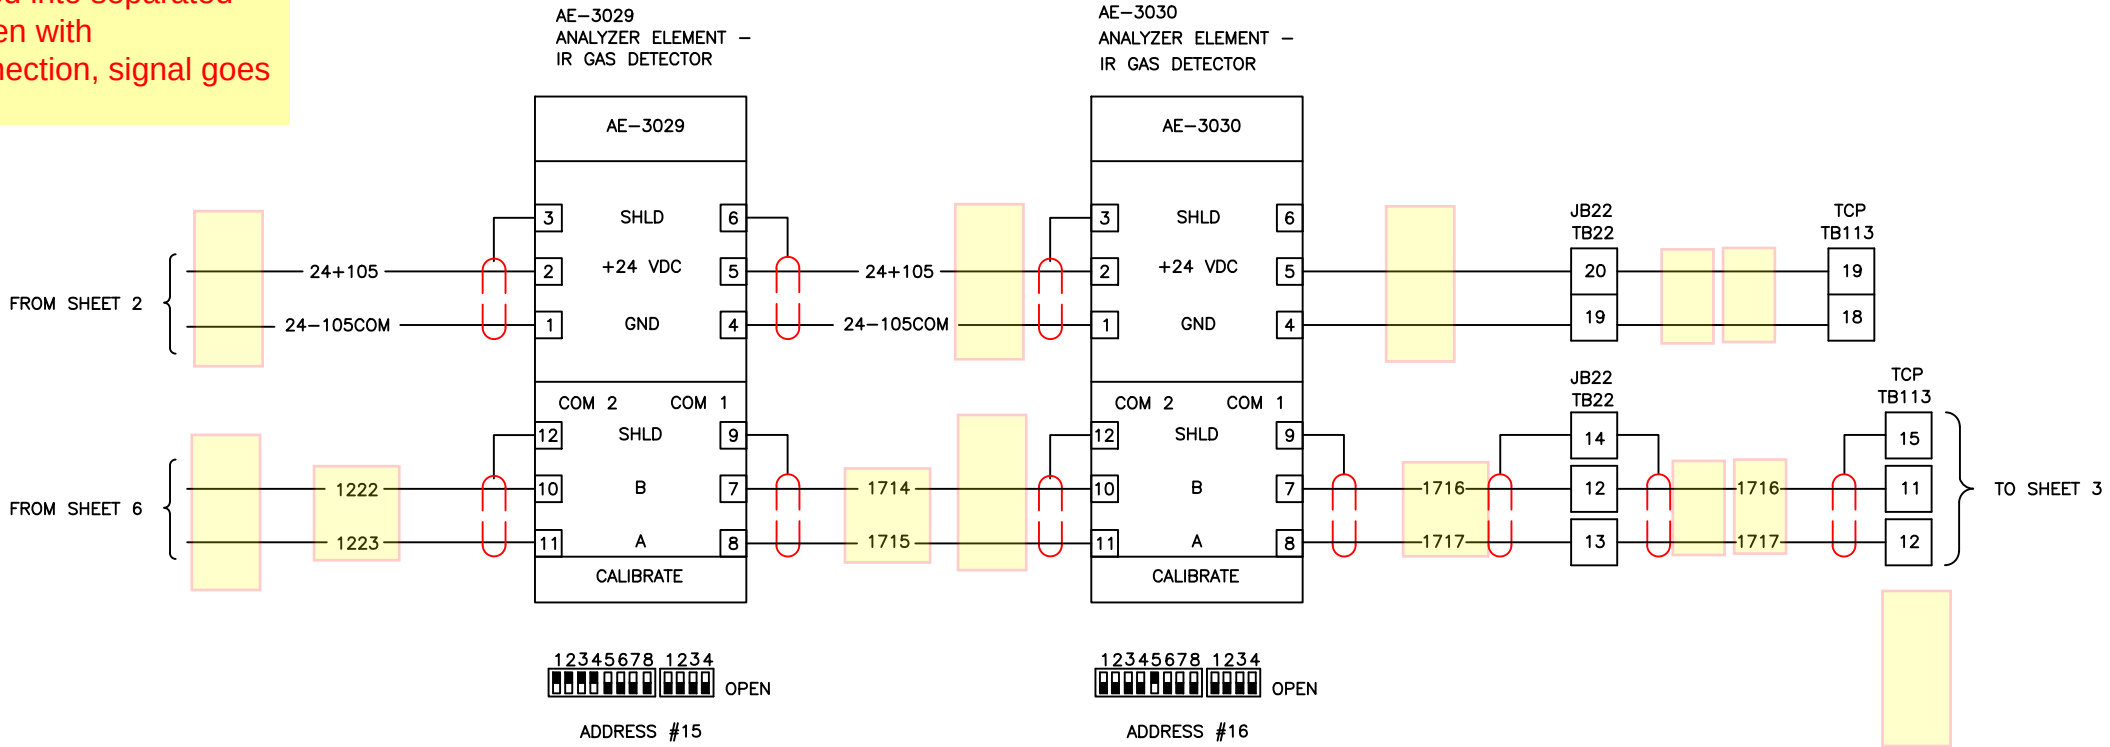

REVISIONS			
REV	DESCRIPTION	DATE	BY
A	ISSUED FOR APPROVAL	07/13/20	MP

THIS DRAWING, DESIGN AND THE DATA CONTAINED THEREIN IS THE PROPERTY OF WILSON FIRE EQUIPMENT AND IS NOT TO BE DISTRIBUTED TO OR USED BY OTHERS WITHOUT THE EXPRESSED WRITTEN CONSENT OF WILSON FIRE EQUIPMENT.

SCALE:	AS SHOWN	DATE
DRAWN:	MP	07/13/20
CHECKED:	JV	07/13/20
APPROVED:	JV	07/13/20

WILSON FIRE EQUIPMENT & SERVICE CO.
7303 EMPIRE CENTRAL DRIVE HOUSTON, TEXAS 77040 (713) 896-4747

CUSTOMER INFORMATION

GEN 9
LM2500 XPRESS

LON LOOP
FIRE & GAS DETECTION/
AEROSOL SUPPRESSION SYSTEM
WFE PROJECT # GE-MC



SIZE	DRAWING NO.	REV
B	SW-MC-07 SHEET 7 OF 9	A

NODE ADD	DEVICE TYPE	TAG NAME	DESCRIPTION	NODE CONFIGURATION SETTINGS											
				CONFIG PORT BAUD RATE: 115200	PARITY: NONE	SERIAL PORT PROTOCOL: MODBUS SLAVE	MODBUS BAUD RATE: 115200		PARITY: NONE		BEEPER VOLUME: HIGH	ALLOW LON POINT DISABLING: YES	OPTION CONTROL BOARD: NET:	CONTROL NET MAC ADDRESS:	
1	CONTROLLER														
	CONTROLLER INPUTS			INTPUT 1: NONE	INTPUT 2: NONE	INTPUT 3: NONE	INTPUT 4: NONE			INTPUT 5: NONE		INTPUT 6: NONE	INTPUT 7: NONE	INTPUT 8: NONE	
	CONTROLLER OUTPUTS			OUTPUT 1:	OUTPUT 2:	OUTPUT 3:	OUTPUT4:			OUTPUT 5:		OUTPUT 6	OUTPUT 7:	OUTPUT 8: NONE	
	RELAY-1		FIRE/GAS MONITOR SHUTDOWN												
	RELAY-2		CRITICAL PATH SHUTDOWN												
	RELAY-3		ALARM LEL- TURBINE ROOM												
	RELAY-4		SHUTDOWN LEL- TURBINE ROOM												
	RELAY-5		F&G SUPPRESANT AGENT RELEASE (CUSTOMER)												
	RELAY-6		GENERAL ALARM (CUSTOMER)												
	RELAY-7		RELAY FAULT (CUSTOMER)												
	RELAY-8		AEROSOL DISCHARGE SIGNAL												

NODE ADD	DEVICE TYPE	TAG NAME	DESCRIPTION	NODE CONFIGURATION SETTINGS											
10	EDIO-01	EDIO-01								12345678 #10 OPEN					
	CH 1	JB18-1	HS-3093, 3092 HAND SWITCH-MANUAL RELEASE	CHANNEL TYPE: INPUT	SUPERVISION: OPENS	STATIC LOGIC FIRE MODE (INPUT): ALARM	ACTIVATION TIME (INPUT): 0 SEC.								
	CH 2	JB18-2	YSA-3006B HORN (OUTSIDE TURBINE ENCLOSURE)	CHANNEL TYPE: OUTPUT	SUPERVISION: OPENS	STATIC LOGIC MODE (INPUT): SUPERVISORY	ACTIVATION TIME (INPUT): CONTINUOUS								
	CH 3	JB18-3	YSA-3006A HORN (INSIDE TURBINE ENCLOSURE)	CHANNEL TYPE: OUTPUT	SUPERVISION: OPENS	STATIC LOGIC MODE (INPUT): SUPERVISORY	ACTIVATION TIME (INPUT): CONTINUOUS								
	CH 4	JB18-4	TS-3003, 3014 THERMAL DETECTOR (TURBINE ENCLOSURE)	CHANNEL TYPE: INPUT	SUPERVISION: OPENS	STATIC LOGIC FIRE MODE (INPUT): ALARM	ACTIVATION TIME (INPUT): 0 SEC.								
	CH 5	JB18-5	YSL-3041 BEACON (OUTSIDE TURBINE ENCLOSURE)	CHANNEL TYPE: OUTPUT	SUPERVISION: OPENS	STATIC LOGIC MODE (INPUT): SUPERVISORY	ACTIVATION TIME (INPUT): CONTINUOUS								
	CH 6	JB18-6	YSL-3042 BEACON (OUTSIDE TURBINE ENCLOSURE)	CHANNEL TYPE: OUTPUT	SUPERVISION: OPENS	STATIC LOGIC MODE (INPUT): SUPERVISORY	ACTIVATION TIME (INPUT): CONTINUOUS								
	CH 7	JB18-7	YSL-3036 BEACON (INSIDE TURBINE ENCLOSURE)	CHANNEL TYPE: OUTPUT	SUPERVISION: OPENS	STATIC LOGIC MODE (INPUT): SUPERVISORY	ACTIVATION TIME (INPUT): CONTINUOUS								
	CH 8	JB18-8	HS-3040 HORN ACKNOWLEDGE (TURBINE ENCLOSURE)	CHANNEL TYPE: INPUT	SUPERVISION: OPENS	STATIC LOGIC MODE (INPUT): SUPERVISORY	ACTIVATION TIME (INPUT): 0 SEC.								

REVISIONS			
REV	DESCRIPTION	DATE	BY
A	ISSUED FOR APPROVAL	07/13/20	MP

THIS DRAWING, DESIGN AND THE DATA CONTAINED THEREIN IS THE PROPERTY OF WILSON FIRE EQUIPMENT AND IS NOT TO BE DISTRIBUTED TO OR USED BY OTHERS WITHOUT THE EXPRESSED WRITTEN CONSENT OF WILSON FIRE EQUIPMENT.

SCALE:	AS SHOWN	DATE
DRAWN:	MP	07/13/20
CHECKED:	JV	07/13/20
APPROVED:	JV	07/13/20

WILSON FIRE EQUIPMENT & SERVICE CO. 7303 EMPIRE CENTRAL DRIVE HOUSTON, TEXAS 77040 (713) 896-4747	
CUSTOMER INFORMATION	
GEN 9	
LM2500 XPRESS	
LON LIST FIRE & GAS DETECTION/ AEROSOL SUPPRESSION SYSTEM WFE PROJECT # GE-MC	

		
SIZE	DRAWING NO.	REV
B	SW-MC-08 SHEET 8 OF 9	A

NODE ADD	DEVICE TYPE	TAG NAME	DESCRIPTION	NODE CONFIGURATION SETTINGS										
11	EDIO-02	EDIO-02								12345678 #11 OPEN				
	CH 1	JB18-1												
	CH 2	JB18-2												
	CH 3	JB18-3												
	CH 4	JB18-4												
	CH 5	JB18-5	YSZ-3171 AEROSOL FIRE SUPPRESSANT (TURBINE)	CHANNEL TYPE: OUTPUT	SUPERVISION: OPENS	STATIC LOGIC MODE (INPUT): SUPERVISORY	ACTIVATION TIME (INPUT): CONTINUOUS							
	CH 6	JB18-6	YSZ-3172 AEROSOL FIRE SUPPRESSANT (TURBINE)	CHANNEL TYPE: OUTPUT	SUPERVISION: OPENS	STATIC LOGIC MODE (INPUT): SUPERVISORY	ACTIVATION TIME (INPUT): CONTINUOUS							
	CH 7	JB18-7												
	CH 8	JB18-8												

NODE ADD	DEVICE TYPE	TAG NAME	DESCRIPTION	NODE CONFIGURATION SETTINGS											
12	UD10-DCU	AE-3004A	AE-3004A ANALYZER ELEMENT COMBUSTIBLE GAS DETECTOR	DCU TYPE: EXPLOSIVE	HIGH ALARM: 25	LOW ALARM: 15	CAL LEVEL: 50	GAS MODE: GAS DETECTOR			12345678 #12 OPEN				DEADBAND 5
13	UD10-DCU	AE-3004B	AE-3004B ANALYZER ELEMENT COMBUSTIBLE GAS DETECTOR	DCU TYPE: EXPLOSIVE	HIGH ALARM: 25	LOW ALARM: 15	CAL LEVEL: 50	GAS MODE: GAS DETECTOR			12345678 #13 OPEN				DEADBAND 5
14	UD10-DCU	AE-3004C	AE-3004C ANALYZER ELEMENT COMBUSTIBLE GAS DETECTOR	DCU TYPE: EXPLOSIVE	HIGH ALARM: 25	LOW ALARM: 15	CAL LEVEL: 50	GAS MODE: GAS DETECTOR			12345678 #14 OPEN				DEADBAND 5
15	ECLIPSE	AE-3029	AE-3029 ANALYZER ELEMENT IR GAS DETECTOR	GAS TYPE: METHANE	CAL GAS TYPE: METHANE	CAL METHOD: STD	UNITS: 50% LFL	HIGH ALARM: 10	LOW ALARM: 5		12345678 #15 OPEN				DEADBAND 5
16	ECLIPSE	AE-3030	AE-3030 ANALYZER ELEMENT IR GAS DETECTOR	GAS TYPE: METHANE	CAL GAS TYPE: METHANE	CAL METHOD: STD	UNITS: 50% LFL	HIGH ALARM: 10	LOW ALARM: 5		12345678 #16 OPEN				DEADBAND 5

REVISIONS			
REV	DESCRIPTION	DATE	BY
A	ISSUED FOR APPROVAL	07/13/20	MP

THIS DRAWING, DESIGN AND THE DATA
CONTAINED THEREIN IS THE PROPERTY
OF WILSON FIRE EQUIPMENT AND IS
NOT TO BE DISTRIBUTED TO OR USED
BY OTHERS WITHOUT THE EXPRESSED
WRITTEN CONSENT OF WILSON
FIRE EQUIPMENT.

SCALE:	AS SHOWN	DATE
DRAWN:	MP	07/13/20
CHECKED:	JV	07/13/20
APPROVED:	JV	07/13/20

WILSON FIRE EQUIPMENT & SERVICE CO.
7303 EMPIRE CENTRAL DRIVE HOUSTON, TEXAS 77040 (713) 896-4747

CUSTOMER INFORMATION

GEN 9

LM2500 XPRESS

LON LIST
FIRE & GAS DETECTION /
AEROSOL SUPPRESSION SYSTEM
WFE PROJECT # GE-MC



SIZE	DRAWING NO.	REV
B	SW-MC-09 SHEET 9 OF 9	A